



FOYER/GARAGE

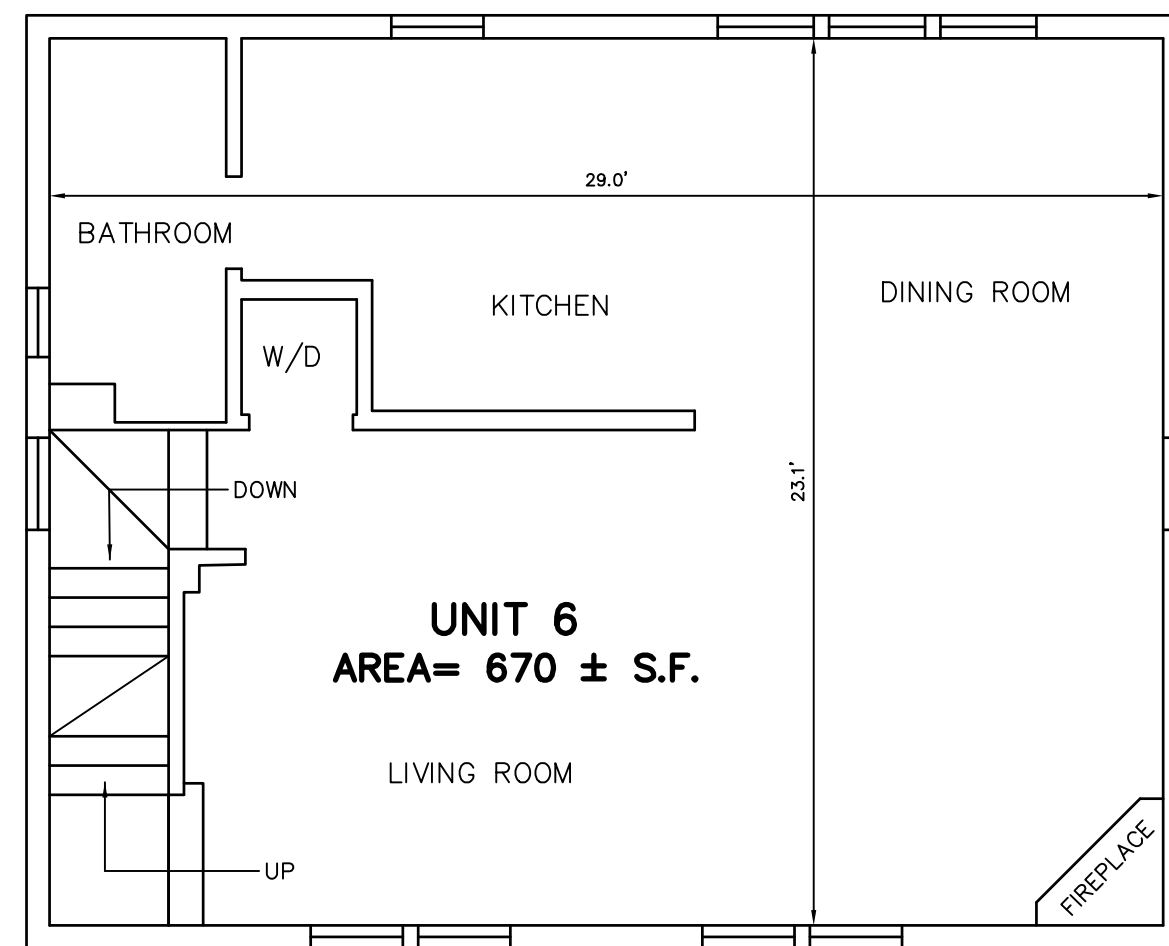

1ST FLOOR

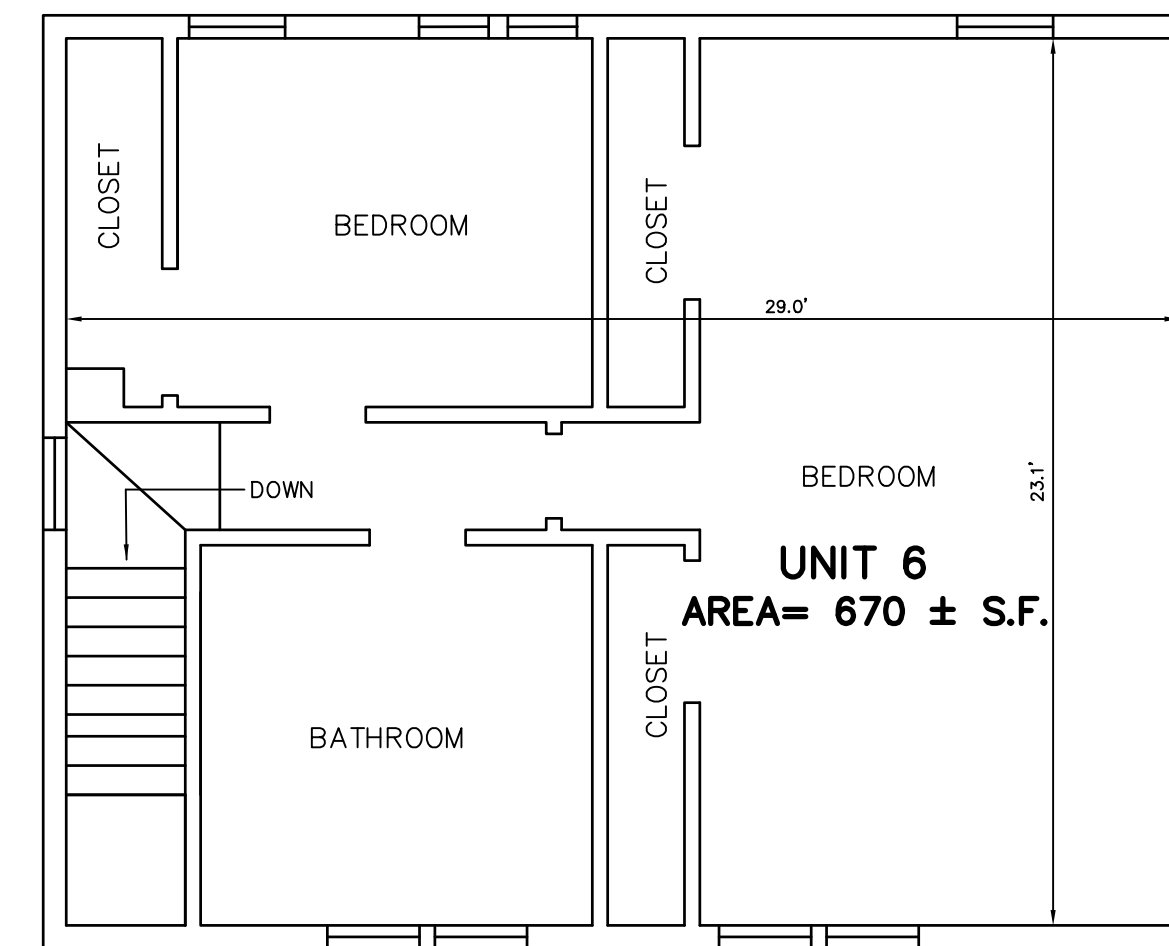


2ND FLOOR

UNIT 6	
GARAGE	474 ± S.F.
ENTRY/FOYER	196 ± S.F.
FIRST FLOOR	670 ± S.F.
SECOND FLOOR	670 ± S.F.
TOTAL	2,010 ± S.F.

FOR REGISTRY USE ONLY

LEGEND
W/D WASHER / DRYER

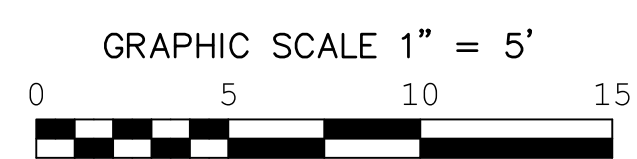

I CERTIFY THAT THIS PLAN CONFORMS TO THE RULES AND REGULATIONS OF THE REGISTERS OF DEEDS.

I CERTIFY THAT THIS PLAN FULLY AND ACCURATELY DEPICTS THE LAYOUT, LOCATION, UNIT NUMBER AND DIMENSIONS OF THE UNIT NUMBERED 6 AT 23 WASHINGTON STREET, BEVERLY, MA, AS BUILT.

DATE

PROFESSIONAL LAND SURVEYOR

FLOOR PLANS
FOR
PHASE 3
CAPTAINS LANDING CONDOMINIUM
BEVERLY

SCALE 1" = 5' OCTOBER 28, 2021

NORTH SHORE SURVEY CORPORATION

GAIL L. SMITH, PLS #35043

14 BROWN STREET - SALEM, MA
(978) 744-4800

#5056