
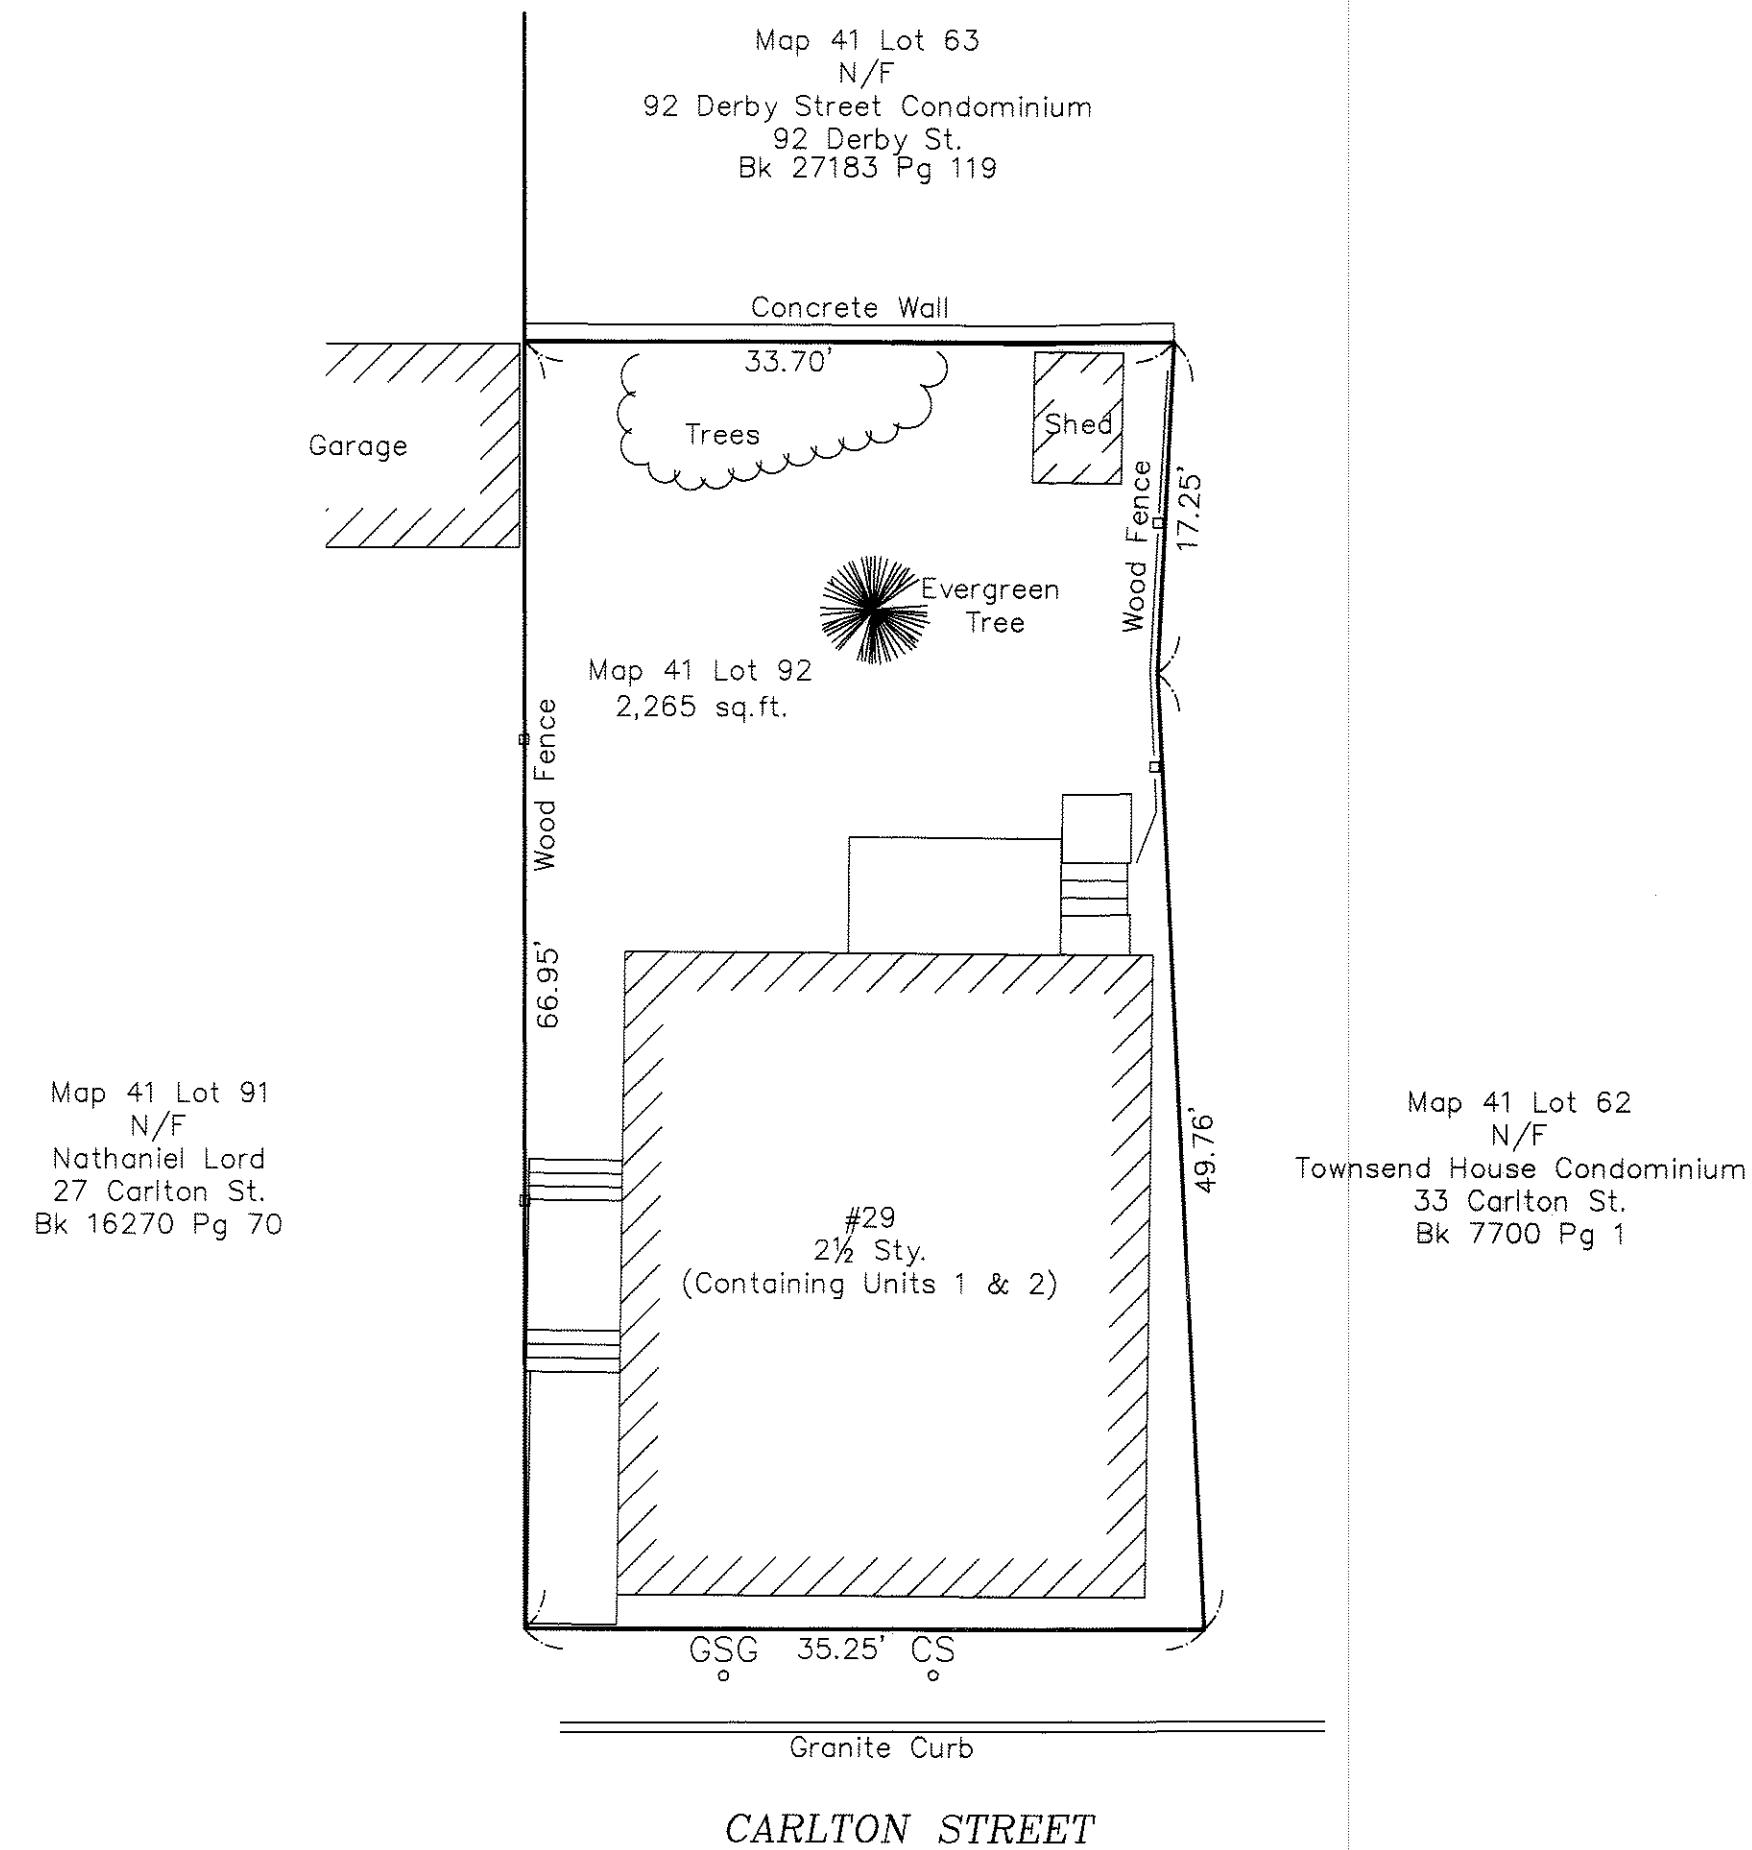


PLAN BOOK 423 PLAN 83

ESSEX REGISTRY OF DEEDS, SO. DIST.
SALEM, MASS.
Received April 28, 2010
with Mstr. Deed, William
Naszka Condominium
Rec. Bk 216 Pg 476
Attest: *J. LeBlanc*
Register of Deeds

FOR REGISTRY USE ONLY

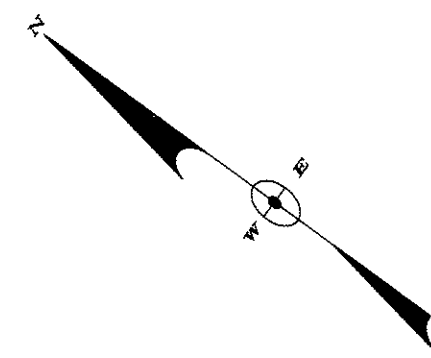

SITE PLAN

REFERENCES:


- 1) Deed Book 4317 Page 532.
- 2) Plan in Book 2011 Page 600.
- 3) Plan Book 409 Plan 60.
- 4) Plan Book 216 Plan 29.

CONDOMINIUM SITE & FLOOR PLANS
FOR
WILLIAM NOSZKA CONDOMINIUM
29 CARLTON STREET
SALEM, MASSACHUSETTS

Prepared By
LeBlanc Survey Associates, Inc.
161 Holten Street
Danvers, MA 01923
(978) 774-6012


January 15, 2010 Scale 1"=10'

HOR. SCALE IN FEET

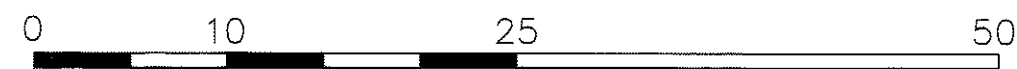

I certify that the property lines shown hereon are the lines dividing existing ownership, and the lines of streets and ways shown are those of public or private streets already established, and that no new lines for division of existing ownership or for new ways are shown.

I certify that this plan was prepared in accordance with the rules and regulations of the Registers of Deeds.

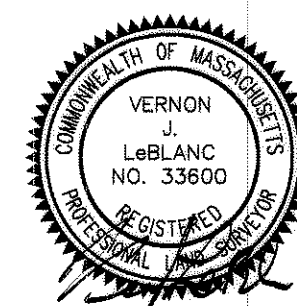


PROFESSIONAL LAND SURVEYOR

4-26-10
DATE

1ST FLOOR


Area Unit 1
755 Sq. Ft.±

Area Unit 2
30 Sq. Ft.±

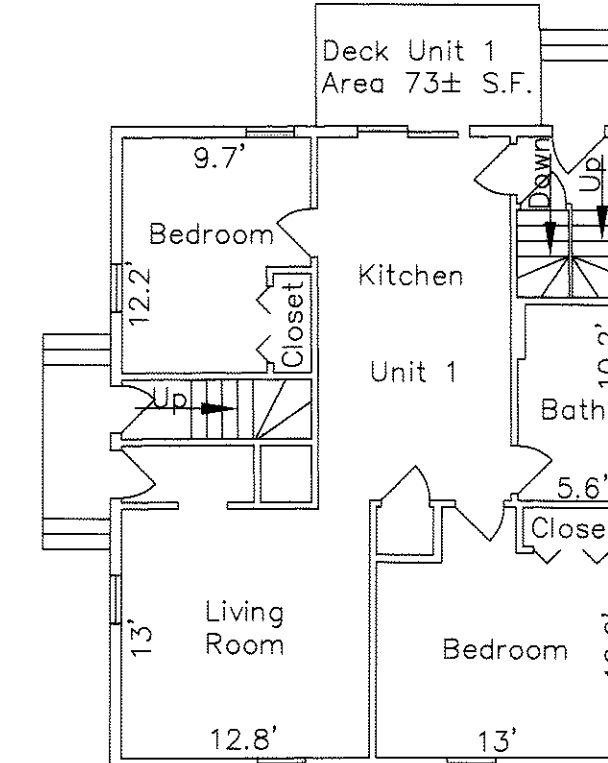


3RD FLOOR

Area Unit 2
409 Sq. Ft.±

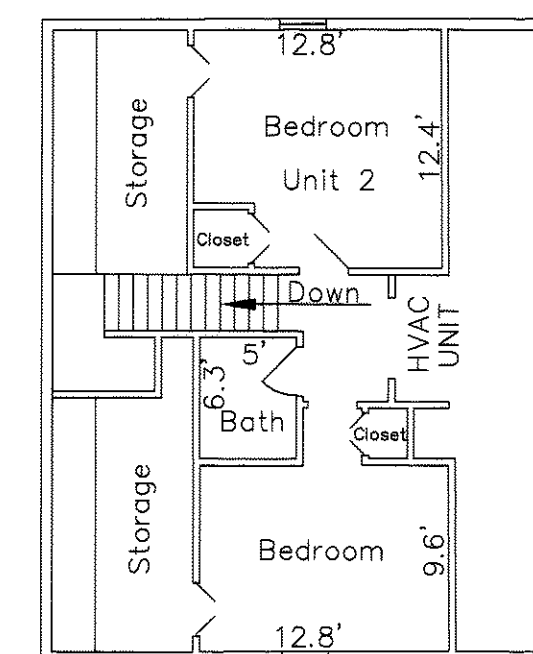


2ND FLOOR

Area Unit 2
848 Sq. Ft.±

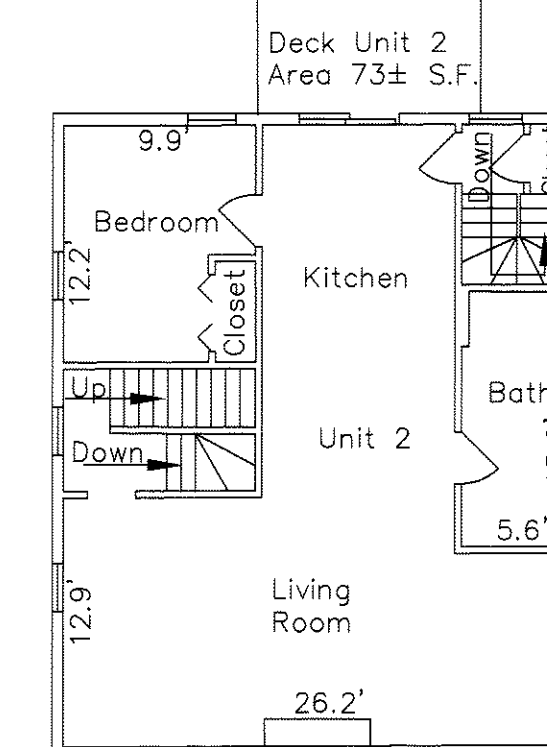

BASEMENT

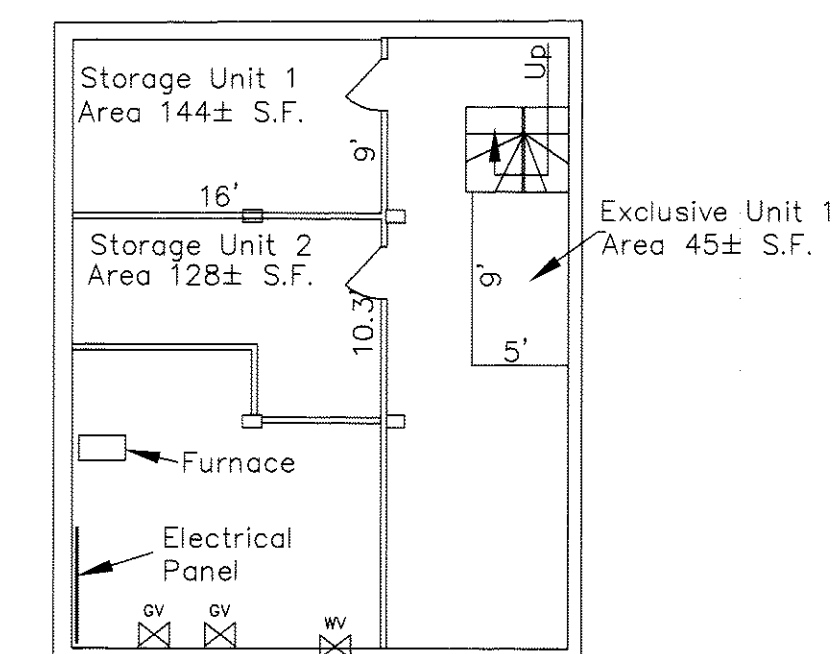

FLOOR PLANS

TOTAL AREA Unit 1

Living Area 755± S.F.

Storage Area 144± S.F.

Deck Area 73± S.F.

Exclusive Use Area 45± S.F.

Total Area 1017± S.F.

TOTAL AREA Unit 2

Living Area 1287± S.F.

Storage Area 128± S.F.

Deck Area 73± S.F.

Total Area 1488± S.F.

I hereby certify that these plans fully and accurately depict the layout, location, unit numbers, and dimensions of the units as built and in existence on January 15, 2010.



PROFESSIONAL LAND SURVEYOR

4-26-10
DATE