

50
322 498

TREEHOUSE DESIGN INC.
14 GREAT HILL ROAD
GLOUCESTER MA
01930

ARCHITECTS CERTIFICATION:


PROJECT NUMBER:

DATE:


PROJECT:
Haven Terrace
Condominium

Nell Blaine House
8 Haven Terrace
10 Haven Terrace


3255-29 (HBP)

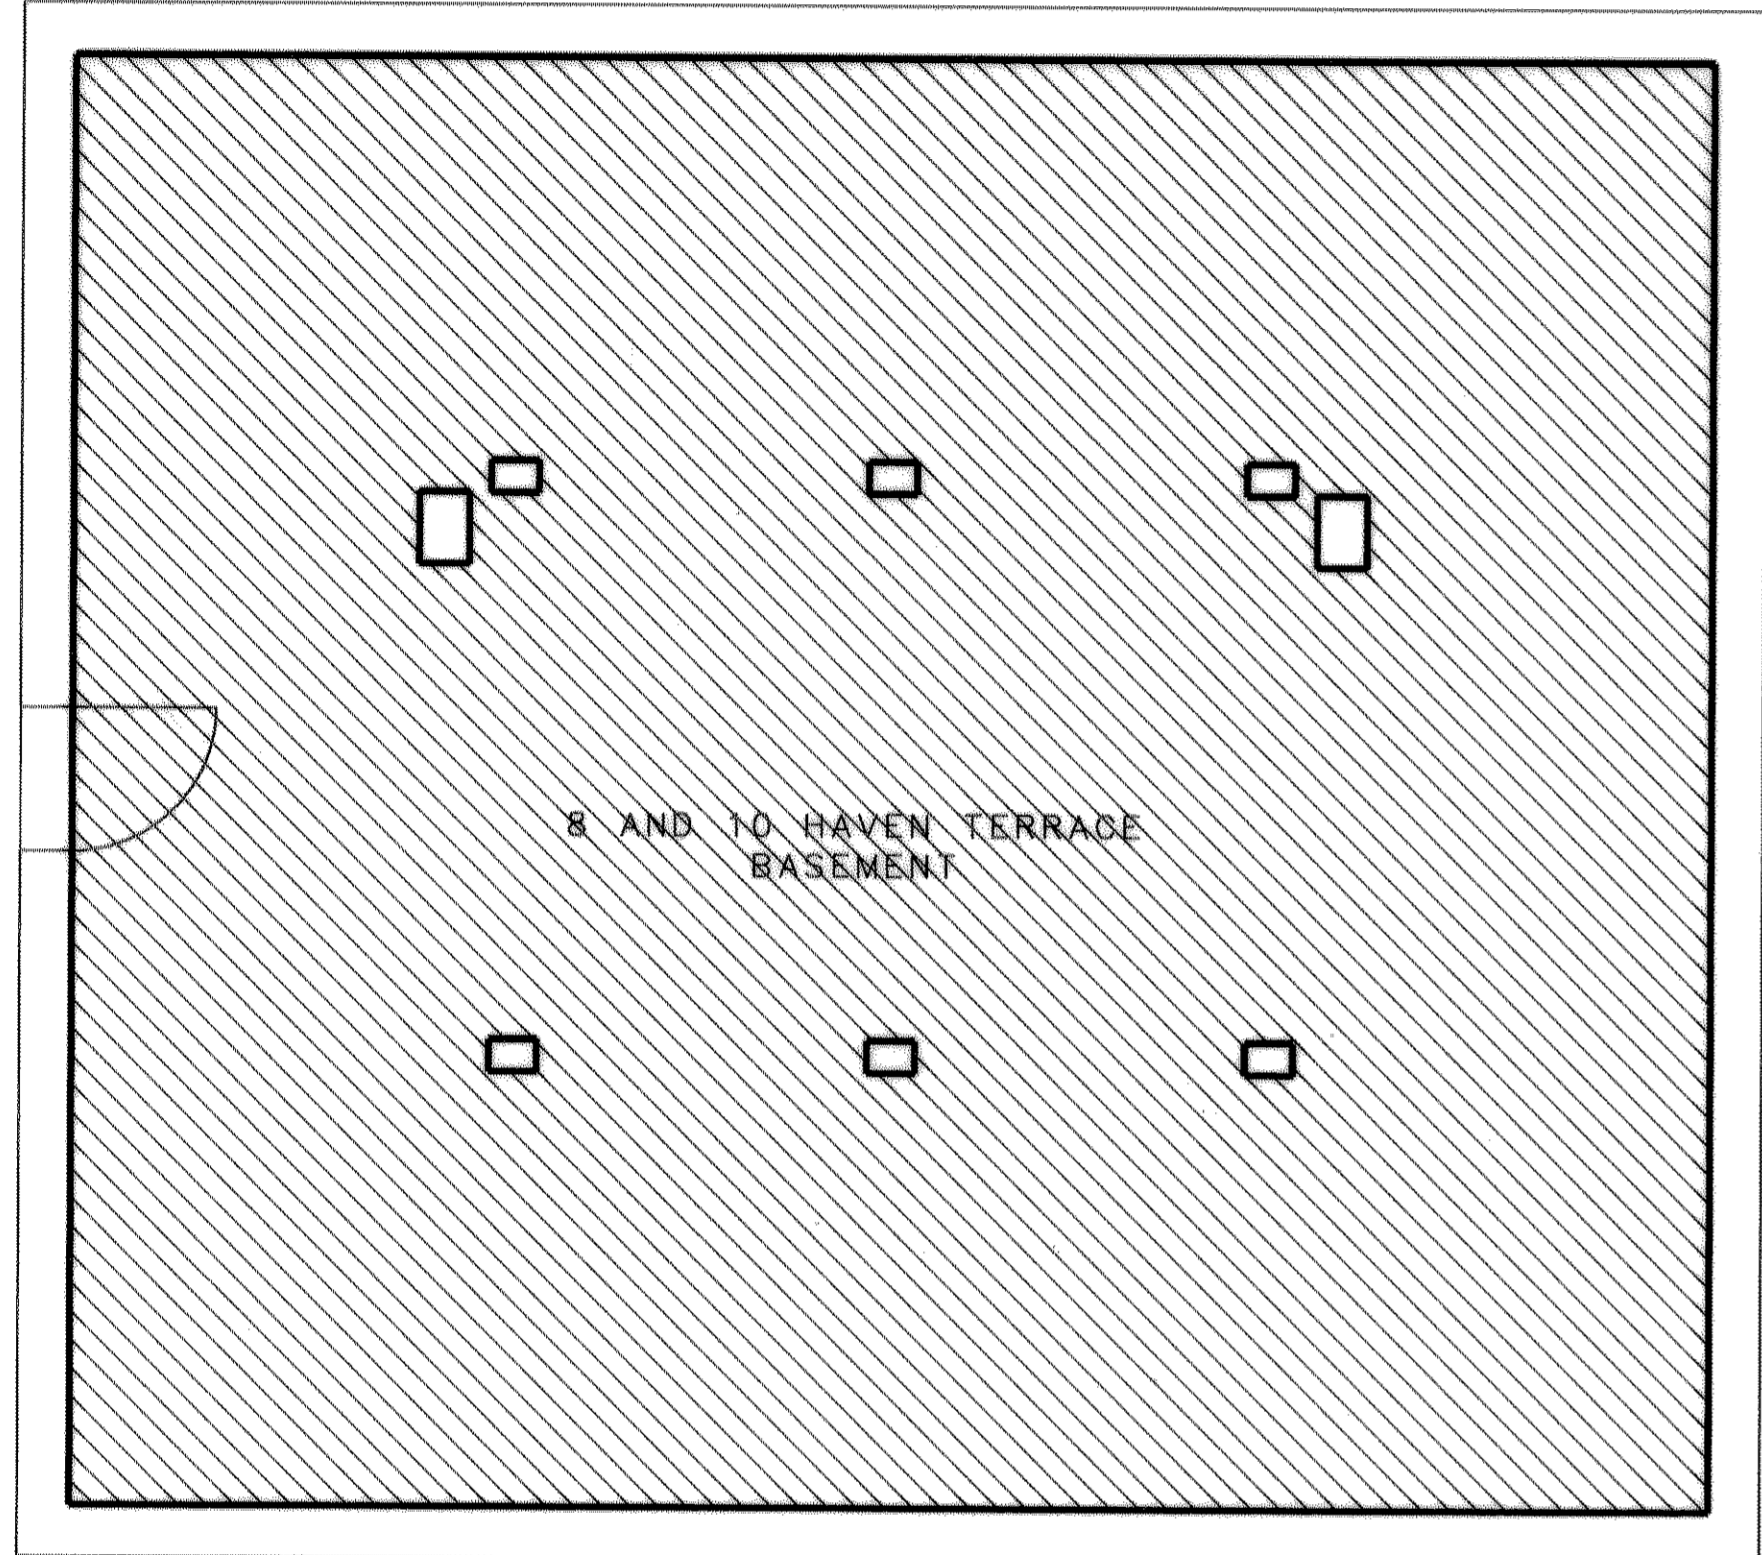


NELL BLAINE HOUSE - BASEMENT

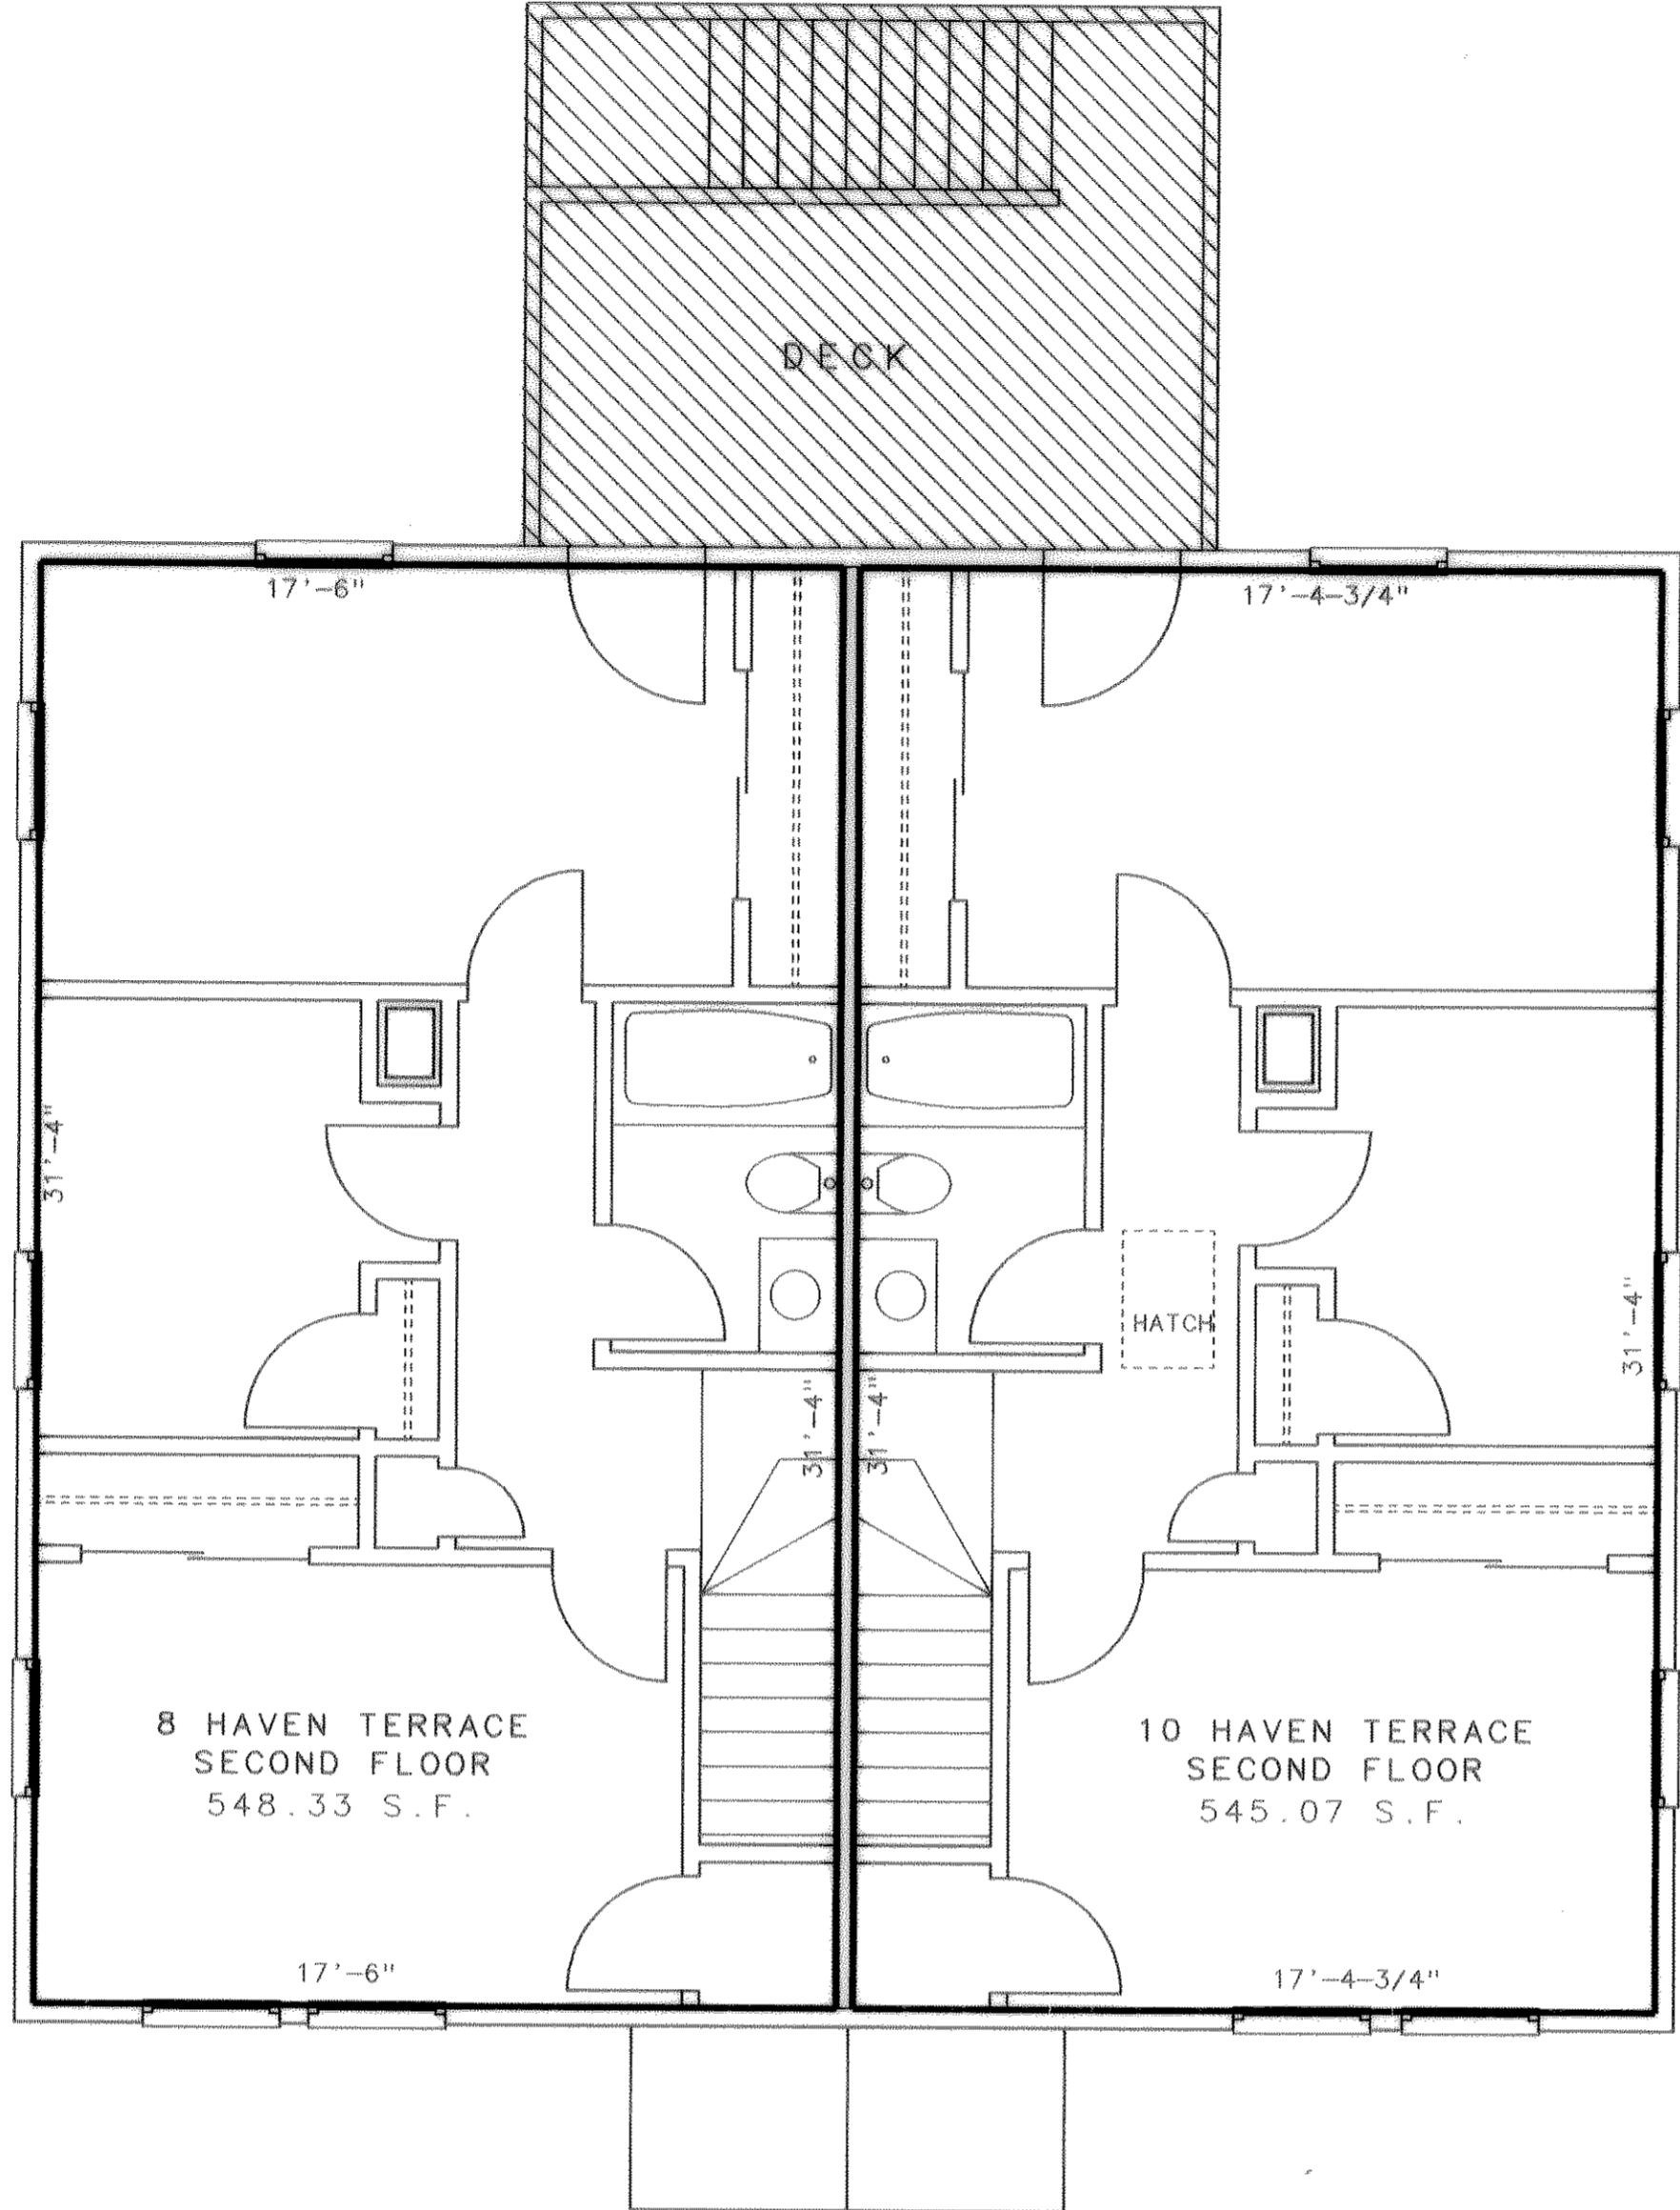

NELL BLAINE HOUSE - SECOND FLOOR

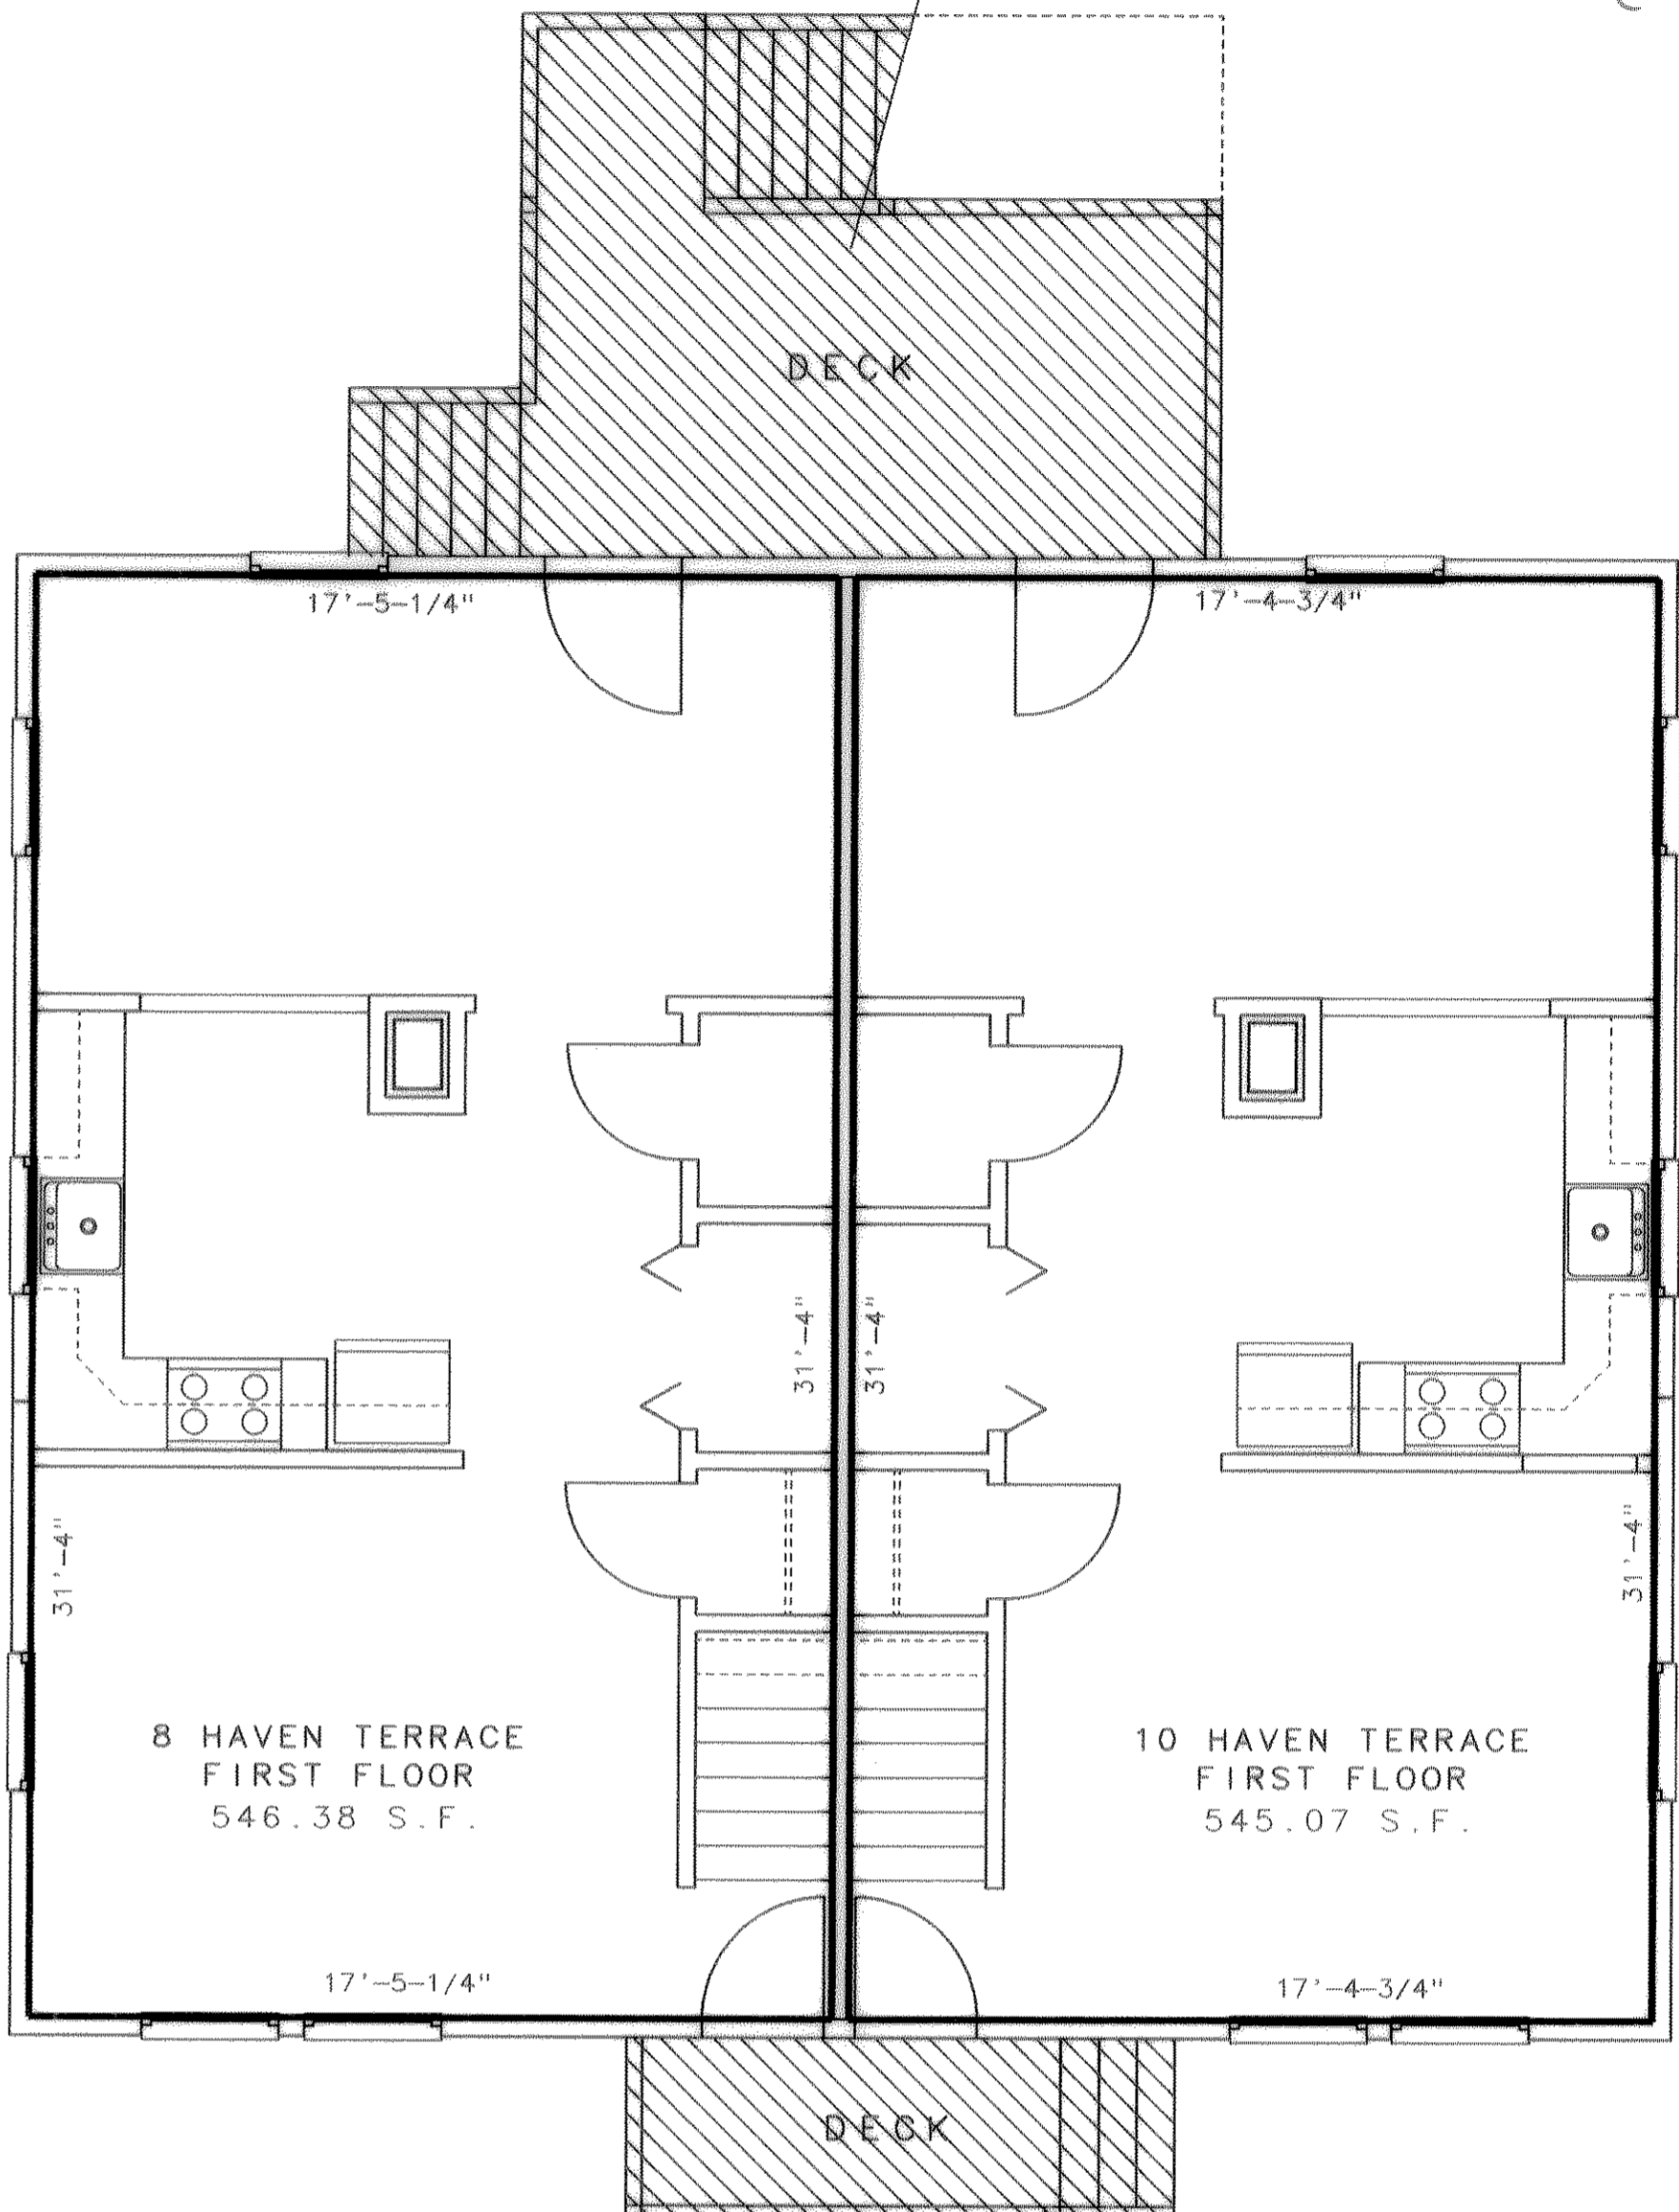

NELL BLAINE HOUSE - FIRST FLOOR

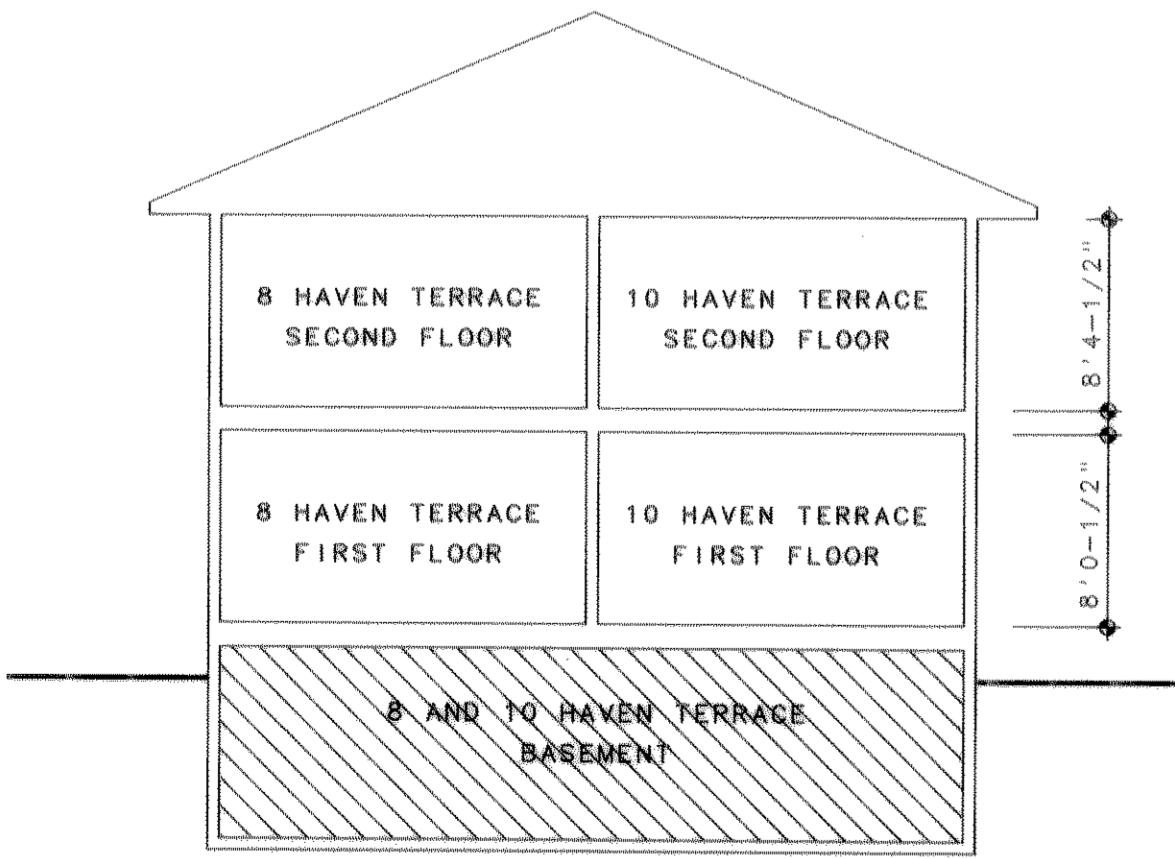

NELL BLAINE HOUSE - CROSS SECTION
NOT TO SCALE

8 HAVEN TERRACE

FIRST FLOOR	546.38 S.F.
SECOND FLOOR	548.33 S.F.
TOTAL	1094.71 S.F.

10 HAVEN TERRACE


FIRST FLOOR	545.07 S.F.
SECOND FLOOR	545.07 S.F.
TOTAL	1090.14 S.F.

 DENOTES LIMITED COMMON AREA

I HEREBY CERTIFY THAT THIS PLAN FULLY AND ACCURATELY DEPICTS THE LAYOUT, LOCATION, UNIT NUMBERS AND DIMENSIONS OF THE UNITS AS BUILT.


I FURTHER CERTIFY THAT THE PREPARATION OF THIS PLAN CONFORMS TO THE RULES AND REGULATIONS OF THE REGISTRY OF DEEDS.

STEPHEN W. LIVERMORE
ARCHITECT, NO. 5294

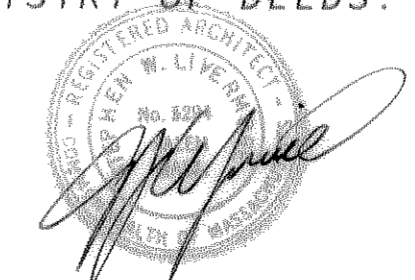

FOR REGISTRY USE ONLY

PLAN BOOK 322 PLAN 60
 Registry of Deeds, No. 451
 2/27/1995
 Recorded with Plan Book 322, Plan 60
 Haven Terrace Condominium
 Rec. B/1995 P. 373
 Attest: John G. Baker
 Register of Deeds 498

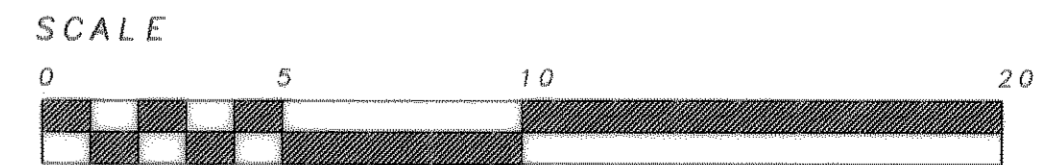

SCALE: 1/4" = 1'-0"

DRAWN BY: TJT / SWL

DRAWING: 8 & 10 Haven Terrace
First Floor Plans
Second Floor Plans

SET: Condominium Plans